
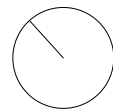
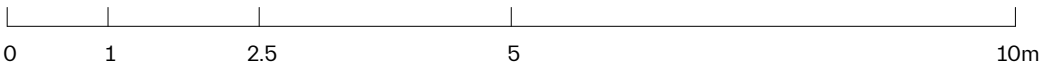



Status		Rev	Date	By	Revision Note
As Built					
Project		Craigmore Cottage			Project No. 131
Client		Mr J McConnachie			
Date	04.2024				Revision
Scale	1:75				A3
Author	JM				
Check	IK				
Drawing					Drawing No.
Proposed Ground Floor Plan					L2011





**Loader Monteith**  
 Loader Monteith Architects Limited  
 30 Bantfield Road, Glasgow, United Kingdom G42 9QH  
 info@loadermonteith.co.uk  
 www.loadermonteith.co.uk

© Drawing is copyright of Loader Monteith Architects Limited  
 Check all dimensions on site. Do not scale from this drawing. Dimensions in millimetres.  
 The client is responsible for all relevant Architectural, Structural and Services Regulations.  
 All rights reserved. No part of this drawing may be reproduced without the prior written consent of Loader Monteith Architects Limited.

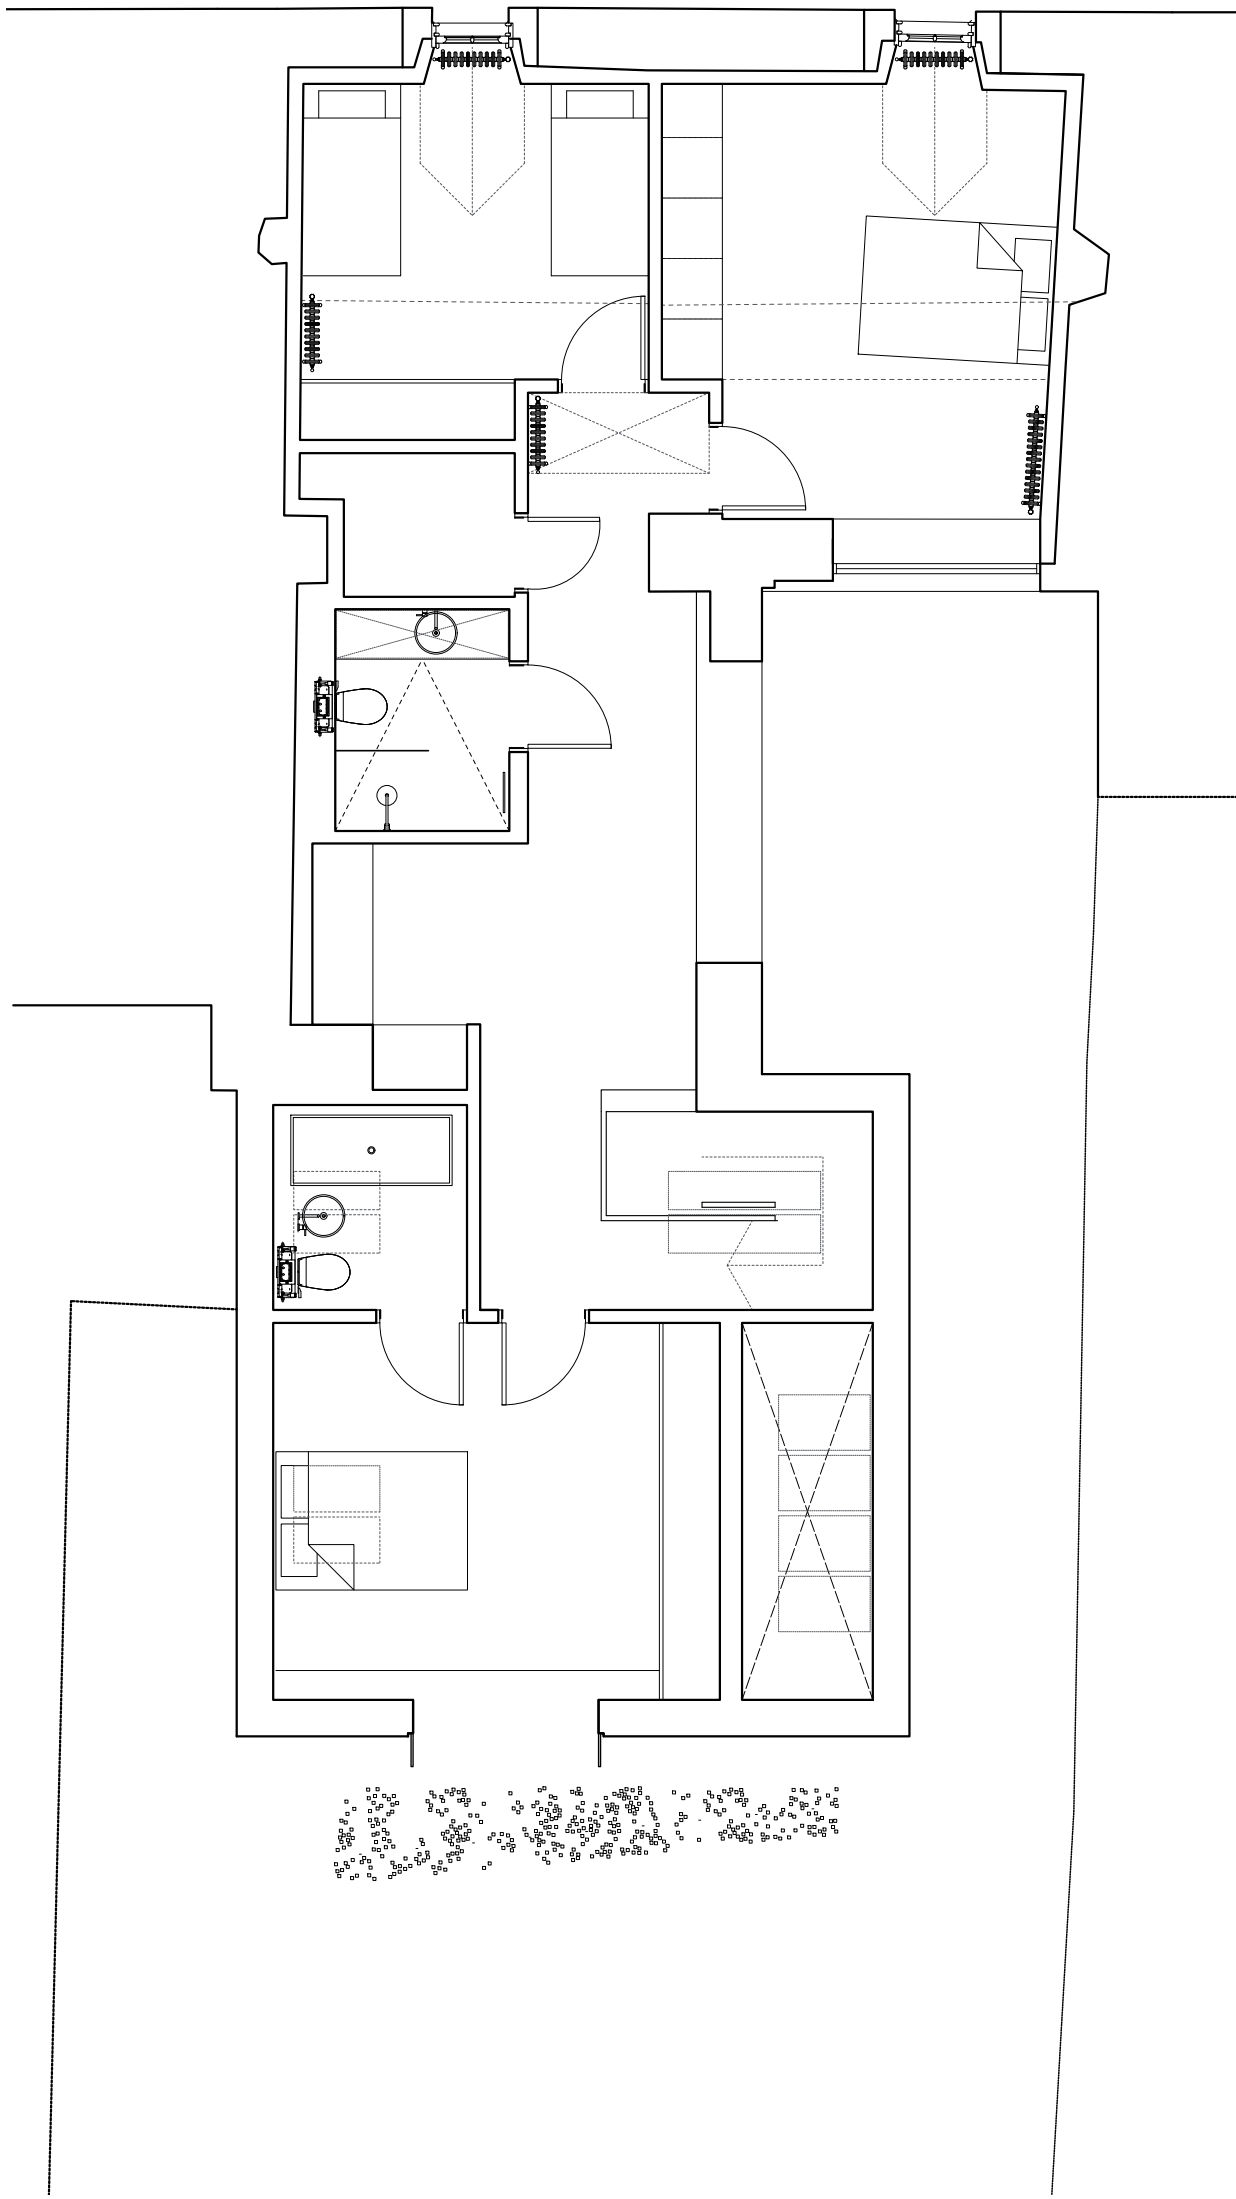

Status		Rev	Date	By	Revision Note
As Built					
 Loader Monteith Architects Limited 20 Battlefield Road, Glasgow, United Kingdom G42 9QH info@loadermonteith.co.uk www.loadermonteith.co.uk		Project	Craigmore Cottage	Project No.	131
		Client	Mr J McConnachie		
		Date	04.2024	Revision	
		Scale	1:75	A3	
		Author	JM		
		Check	IK		
		Drawing			Drawing No.
		Proposed First Floor Plan			L(20)12

© Drawing is copyright of Loader Monteith Architects Limited  
 Check all dimensions on site. Do not scale from this drawing. Dimensions in millimeters.  
 This must be accompanied with all relevant Architectural, Structural and Services Engineering  
 drawings. Errors or omissions are to be reported immediately to the Architect.

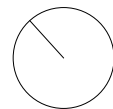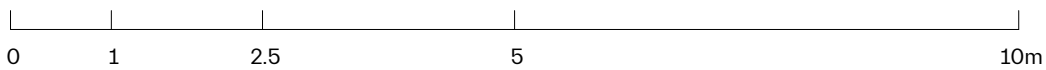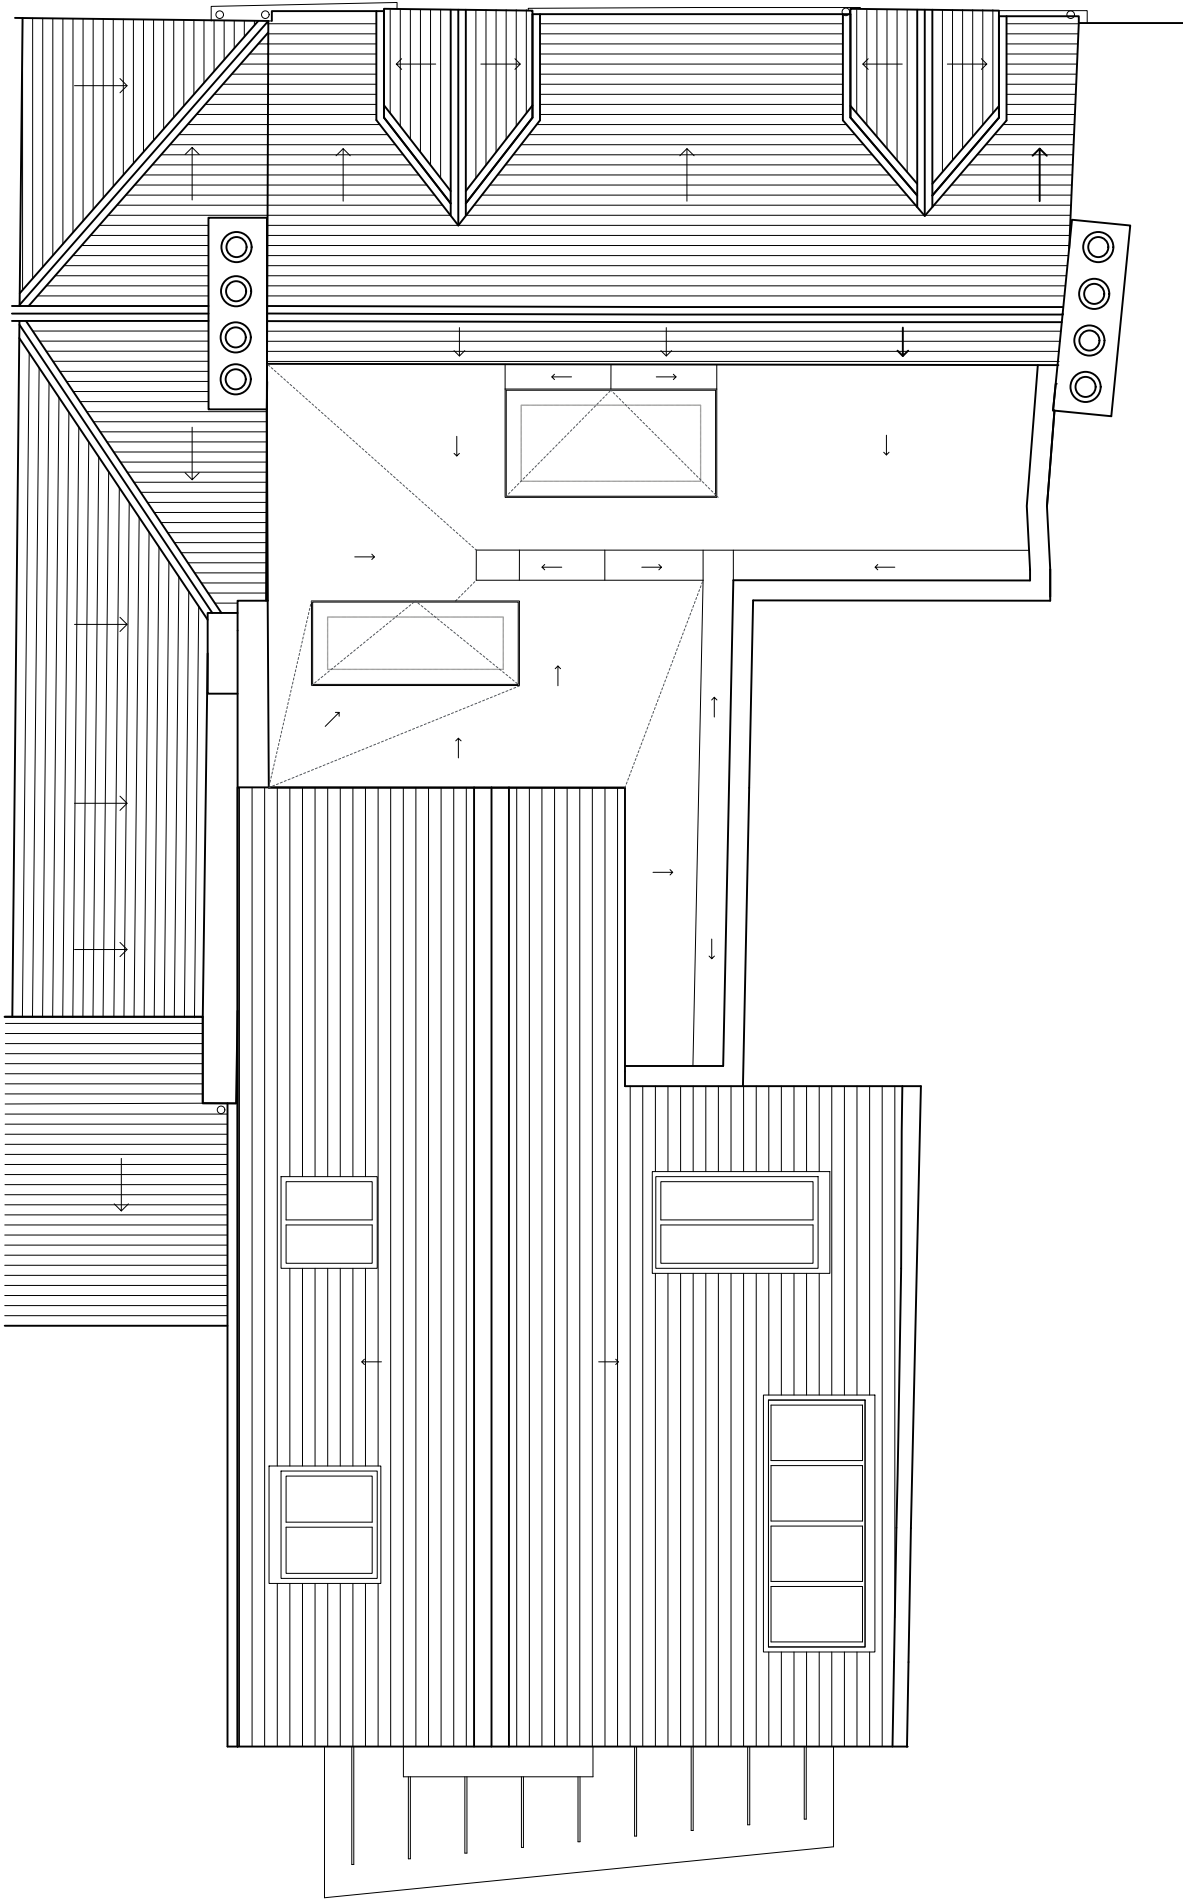

Status  
As Built

Rev	Date	By	Revision Note

**Loader Monteith**  
 Loader Monteith Architects Limited  
 30 Bantfield Road, Glasgow, United Kingdom G42 9QH  
 info@loadermonteith.co.uk  
 www.loadermonteith.co.uk

Project	Project No.
Craigmore Cottage	131
Client	
Mr J McConnachie	
Date	04.2024
Scale	1:75 A3
Author	JM
Check	IK
Drawing	
Proposed First Floor Plan	L[20]13


© Drawing is copyright of Loader Monteith Architects Limited  
 Check all dimensions on site. Do not scale from this drawing. Dimensions in millimetres.  
 To the best of our knowledge and belief, the information contained herein is true and correct.  
 All rights reserved. No part of this drawing may be reproduced without the prior written permission of Loader Monteith Architects Limited.




Rev	Date	By	Revision Note
<b>As Built</b>			
Project			Project No.
Craigmore Cottage			131
Client			
Mr J McConnachie			
Date	06.2024		Revision
Scale	1:75	A3	
Author	JM		
Check	IK		
Drawing			Drawing No.
Existing & Proposed Front Elevations			L[21]11

**Loader Monteith**  
 Loader Monteith Architects Limited  
 310 Battlefield Road, Glasgow, United Kingdom G42 9QH  
 info@loadermonteith.co.uk  
 www.loadermonteith.co.uk

© Drawing is copyright of Loader Monteith Architects Limited  
 Check all dimensions on site. Do not scale from this drawing. Dimensions in millimetres.  
 The user is responsible for all relevant Architectural, Structural and Services Engineers.  
 Drawings of Structures are to be referred to the Architect.

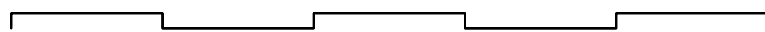

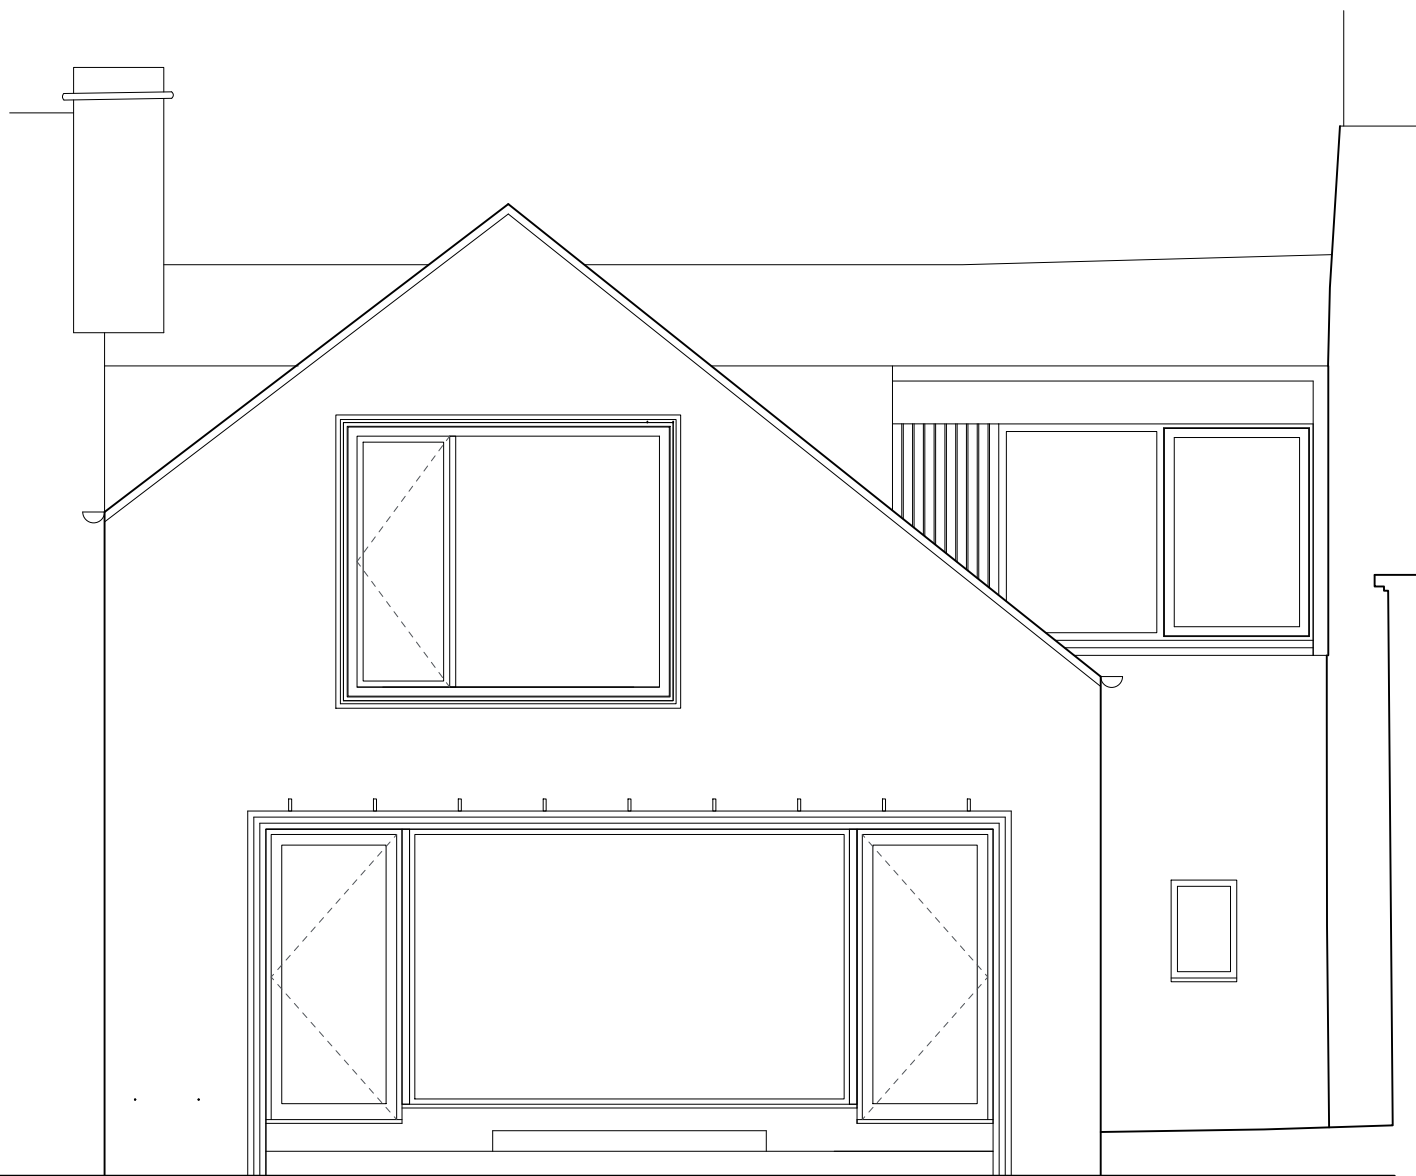

Status


Planning

Rev	Date	By	Revision Note

**Loader Monteith**  
 Loader Monteith Architects Limited  
 30 Bantfield Road, Glasgow, United Kingdom G42 9QH  
 info@loadermonteith.co.uk  
 www.loadermonteith.co.uk

Project	Project No.
Craigmore Cottage	131
Client	
Mr J McConnachie	
Date	25.04.21
Scale	1:75 A3
Author	JM
Check	IK
Drawing	
Proposed Rear Elevation	L[21]12





© Drawing is copyright of Loader Monteith Architects Limited  
 Check all dimensions on site. Do not scale from this drawing. Dimensions in millimetres.  
 The name is registered with all relevant Architects, Structural and Services Engineers.  
 All rights reserved. No part of this drawing may be reproduced without the written permission of the Architect.

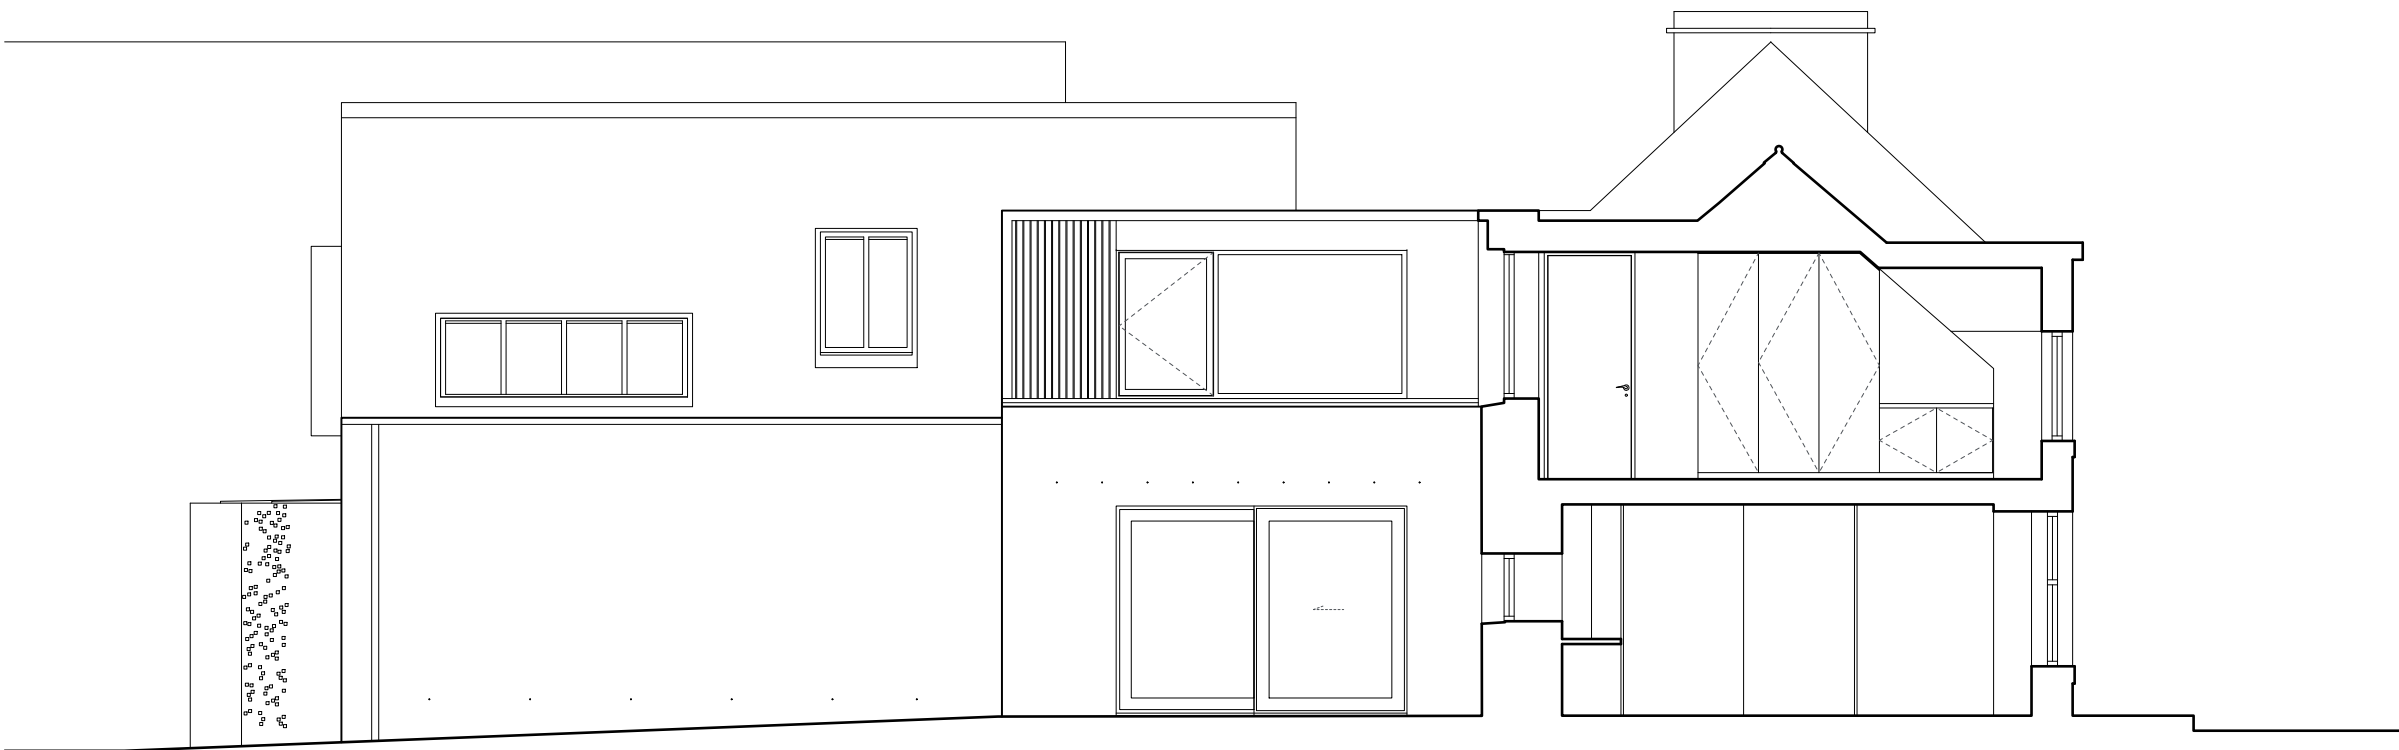


Planning			
Rev	Date	By	Revision Note
<p><b>Project</b> _____ <b>Project No.</b> _____</p> <p><b>Craigmore Cottage</b> 131</p> <p><b>Client</b> _____</p> <p><b>Mr J McConnachie</b></p> <p><b>Date</b> 25.04.21 <b>Revision</b> _____</p> <p><b>Scale</b> 1:75 <b>A3</b> _____</p> <p><b>Author</b> JM _____</p> <p><b>Check</b> IK _____</p> <p><b>Drawing</b> _____ <b>Drawing No.</b> _____</p> <p><b>Proposed Longitudinal Sectional Elevation</b> L(21)13</p>			

**Loader Monteith**  
 Loader Monteith Architects Limited  
 39 Bartfield Road, Glasgow, United Kingdom G42 9QH  
 info@loadermonteith.co.uk  
 www.loadermonteith.co.uk

© Drawing is copyright of Loader Monteith Architects Limited  
 Check all dimensions on site. Do not scale from this drawing. Dimensions in millimetres.  
 The user of this drawing shall remain responsible for its use. Loader Monteith Architects Limited  
 accepts no responsibility for any errors or omissions in this drawing.

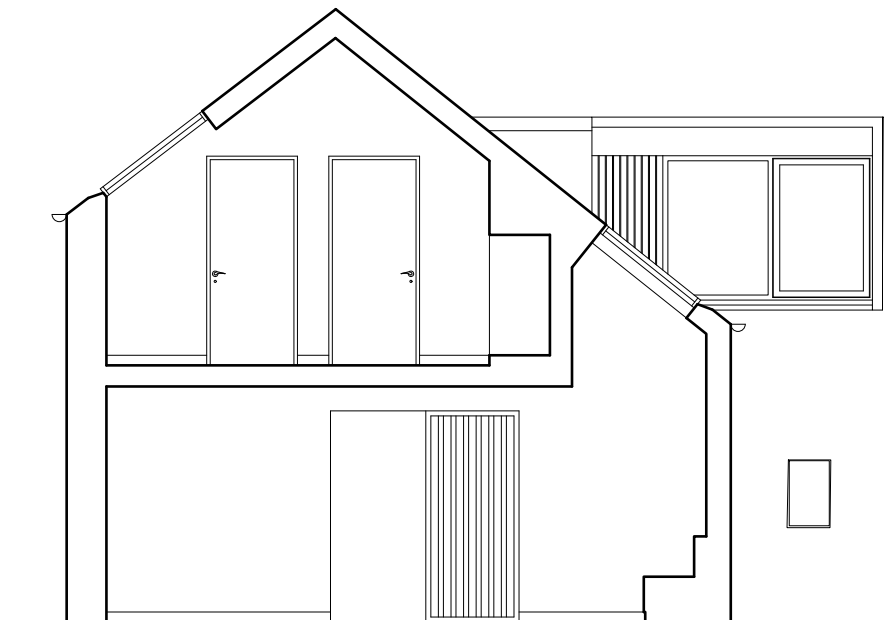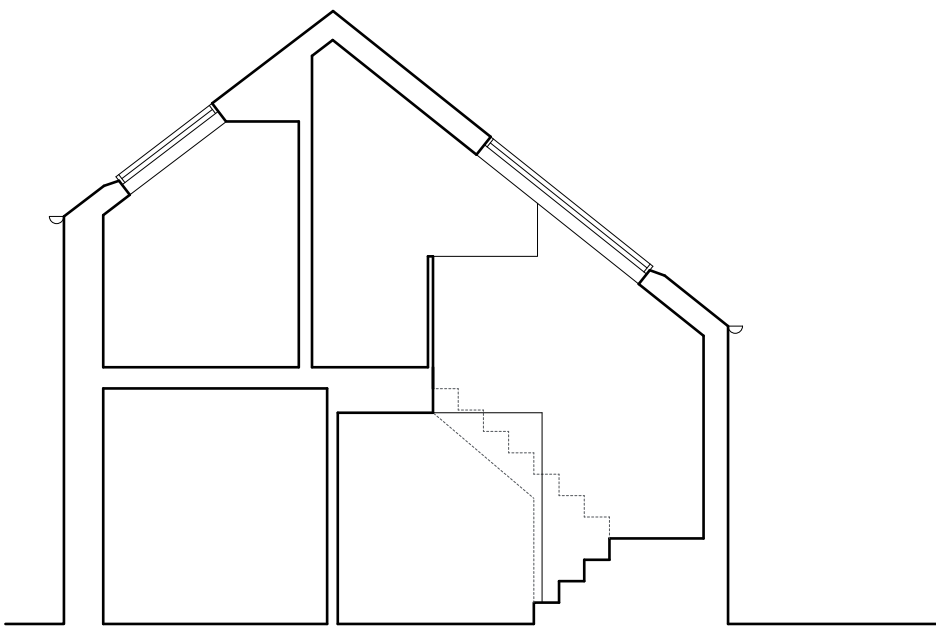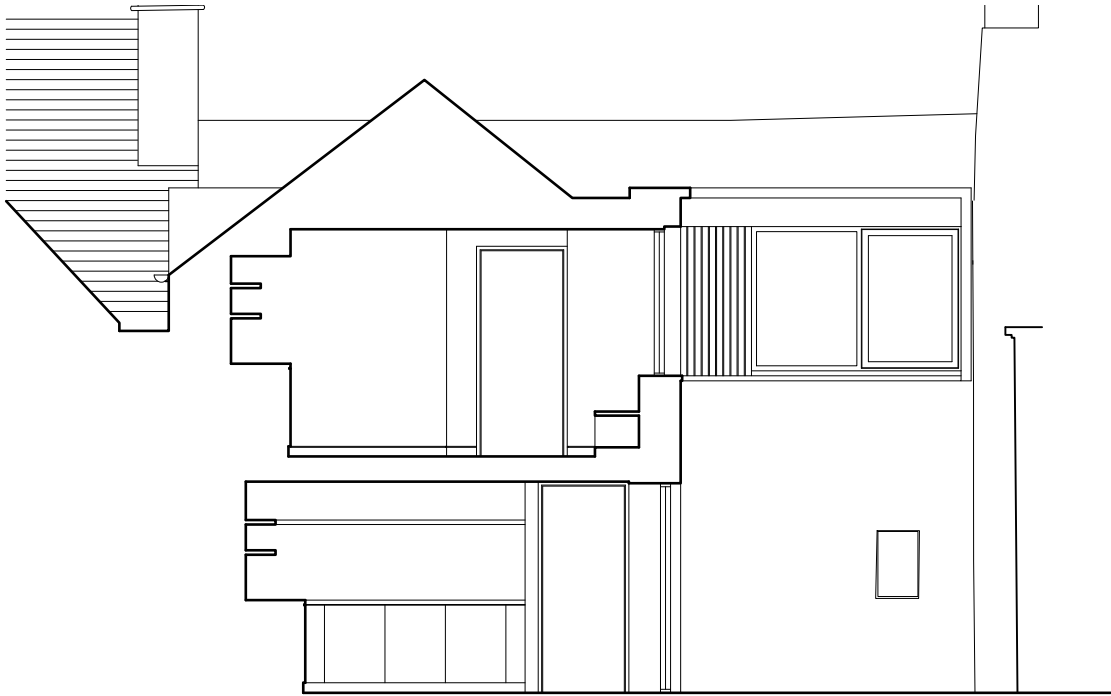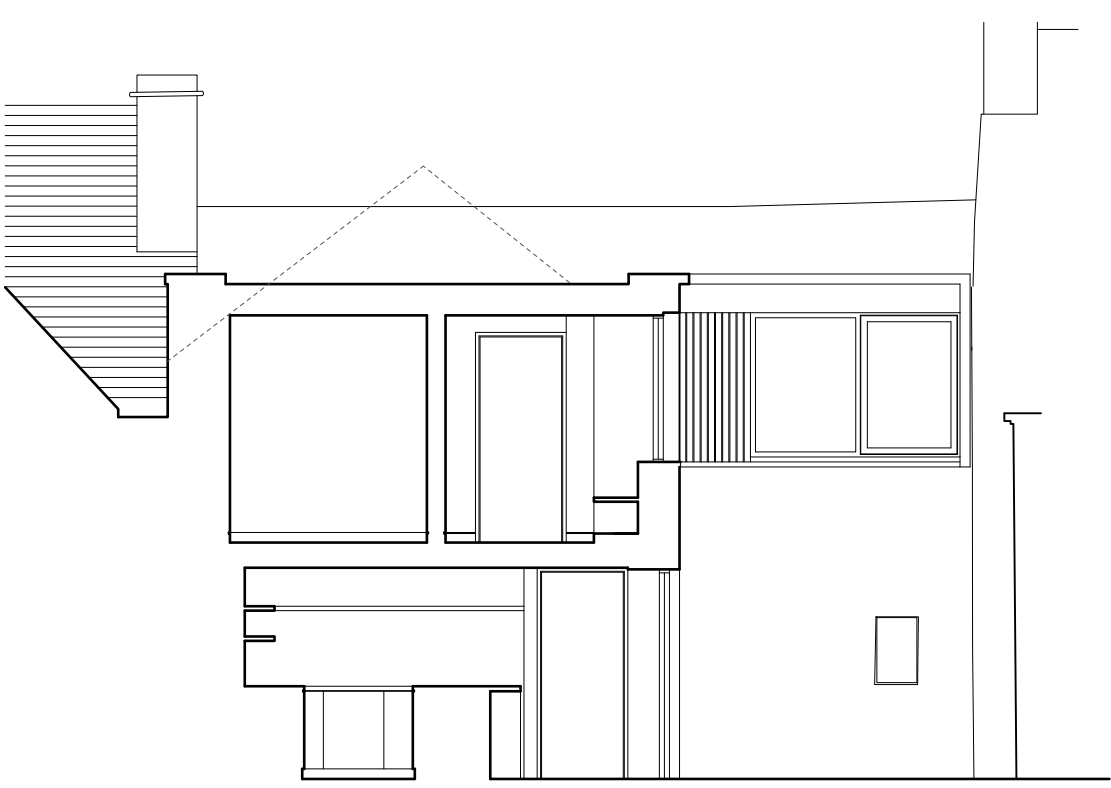

Planning				Status
Rev	Date	By	Revision Note	
 Loader Monteith Architects Limited 30 Bantfield Road, Glasgow, United Kingdom G42 9QH info@loadermonteith.co.uk www.loadermonteith.co.uk				Project No. 131
Client <b>Mr J McConnachie</b>				Revision -
Date	25.04.21			Revision
Scale	1/75	A3		-
Author	JM			
Check	IK			
Drawing				Drawing No.
Proposed Cross Sections				L[21]14

© Drawing is copyright of Loader Monteith Architects Limited  
 Check all dimensions on site. Do not scale from this drawing. Dimensions in millimetres.  
 To the best of our knowledge and belief, the information contained in this drawing is true and correct.  
 No liability is accepted for any loss or damage, whether direct or indirect, arising from the use of this drawing.